


DWG/PN:SEE
AW:56-21190-01 REV.01
CUST. NAME: Tim Tao
ARTWORK PROOF:#2

ARTWORK-POD

INSIDE BLUE BOXES ARE DYNAMIC FIELDS
GET ENTERIES BY CM SITE. SEE BOM PROVIDE BY CISCO

Model: CP-8851

For dimension callout see DWG# 471-00782-01 REV.01

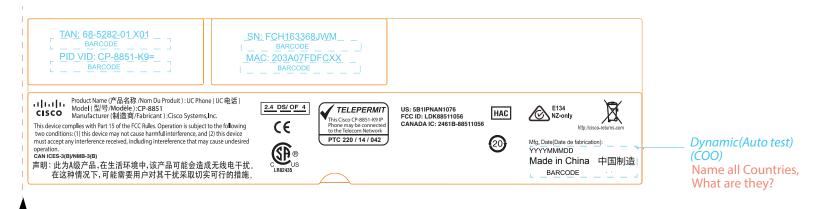

_ PFERFORATION LINE BETWEEN LABEL SET

NOTES:	
A) Material	
Mat Ref: 338T-J1A (WORLDMARK)	
Ribbon: DPW7424	
B) COLORS	C) FONTS
1) CUSTOM BLACK	1)
2) VARNISH	2)
3) 4)	3)
4)	4)
5)	5)
6)	6)
5) 6) 7)	7)
8)	8)

	LABEL FINISHED COPY:			
LABELS/TILE:				
TILES/PACK:				
LABELS/PACK:				
Matrix Strip: Y	N			

- II N /	ш	$\overline{}$	О	т	^	N.	
			_		_	IV	

DELIVERY TIME CAN ONLY BE MET WITH YOUR COOPERATION. PLEASE ENSURE THE ARTWORK PROOF IS CHECKED CAREFULLY FOR LAYOUT, WORDING, SPELLING, SIZE, COLOR, ETC., THEN, RETURNED WITHIN 24 HOURS, TO ENSURE DELIVERY SCHEDULES ARE MET. THE COLORS DISPLAYED ON THIS PROOF MAY NOT BE ACCURATE; REFER TO PMS OR CISCO COLOR BOOK REFERENCES STATED FOR TRUE REPRESENTATION.

Approved By:	
Title:	Date:

			03				
Red Line i	s cut line						
Dimensions are show Tolerances unless of							
Dimensions Tolerance: ± 0.30mm"							
P2C Tolerance:	± 0.30mm"						
UNIT: mm		ORIGINATION	1 D	ATE	CHECK BY	-	ATE
SCALE: 1:1	SHEET: 1	Chan S.	04/2	4/14			

WM REF. No. Rev.

Description

ECN